

Consulting Engineer's Certification
 It is certified that works herein have been constructed to Local Government standards, relevant approved specifications and the operational works approval. The As-Constructed Drawings for these works constitutes a true and correct record of the works constructed and complies with the design intent.

Signature:RPEQ.....
 Date of Practical Completion:
 Engineering Consultant:


Registered Surveyor's Certification:
 We, R.P.S. AUSTRALIA EAST PTY LTD hereby certify that the vertical and horizontal locations and dimensions shown on this plan are a true and correct record of the As Constructed information.
 Signed

Authorised Delegate
 RPS

**STORMWATER
 AS CONSTRUCTED**

**BIRCHWOOD
 STAGE 1 & 2
 PARK RIDGE**

SHEET 1 of 1

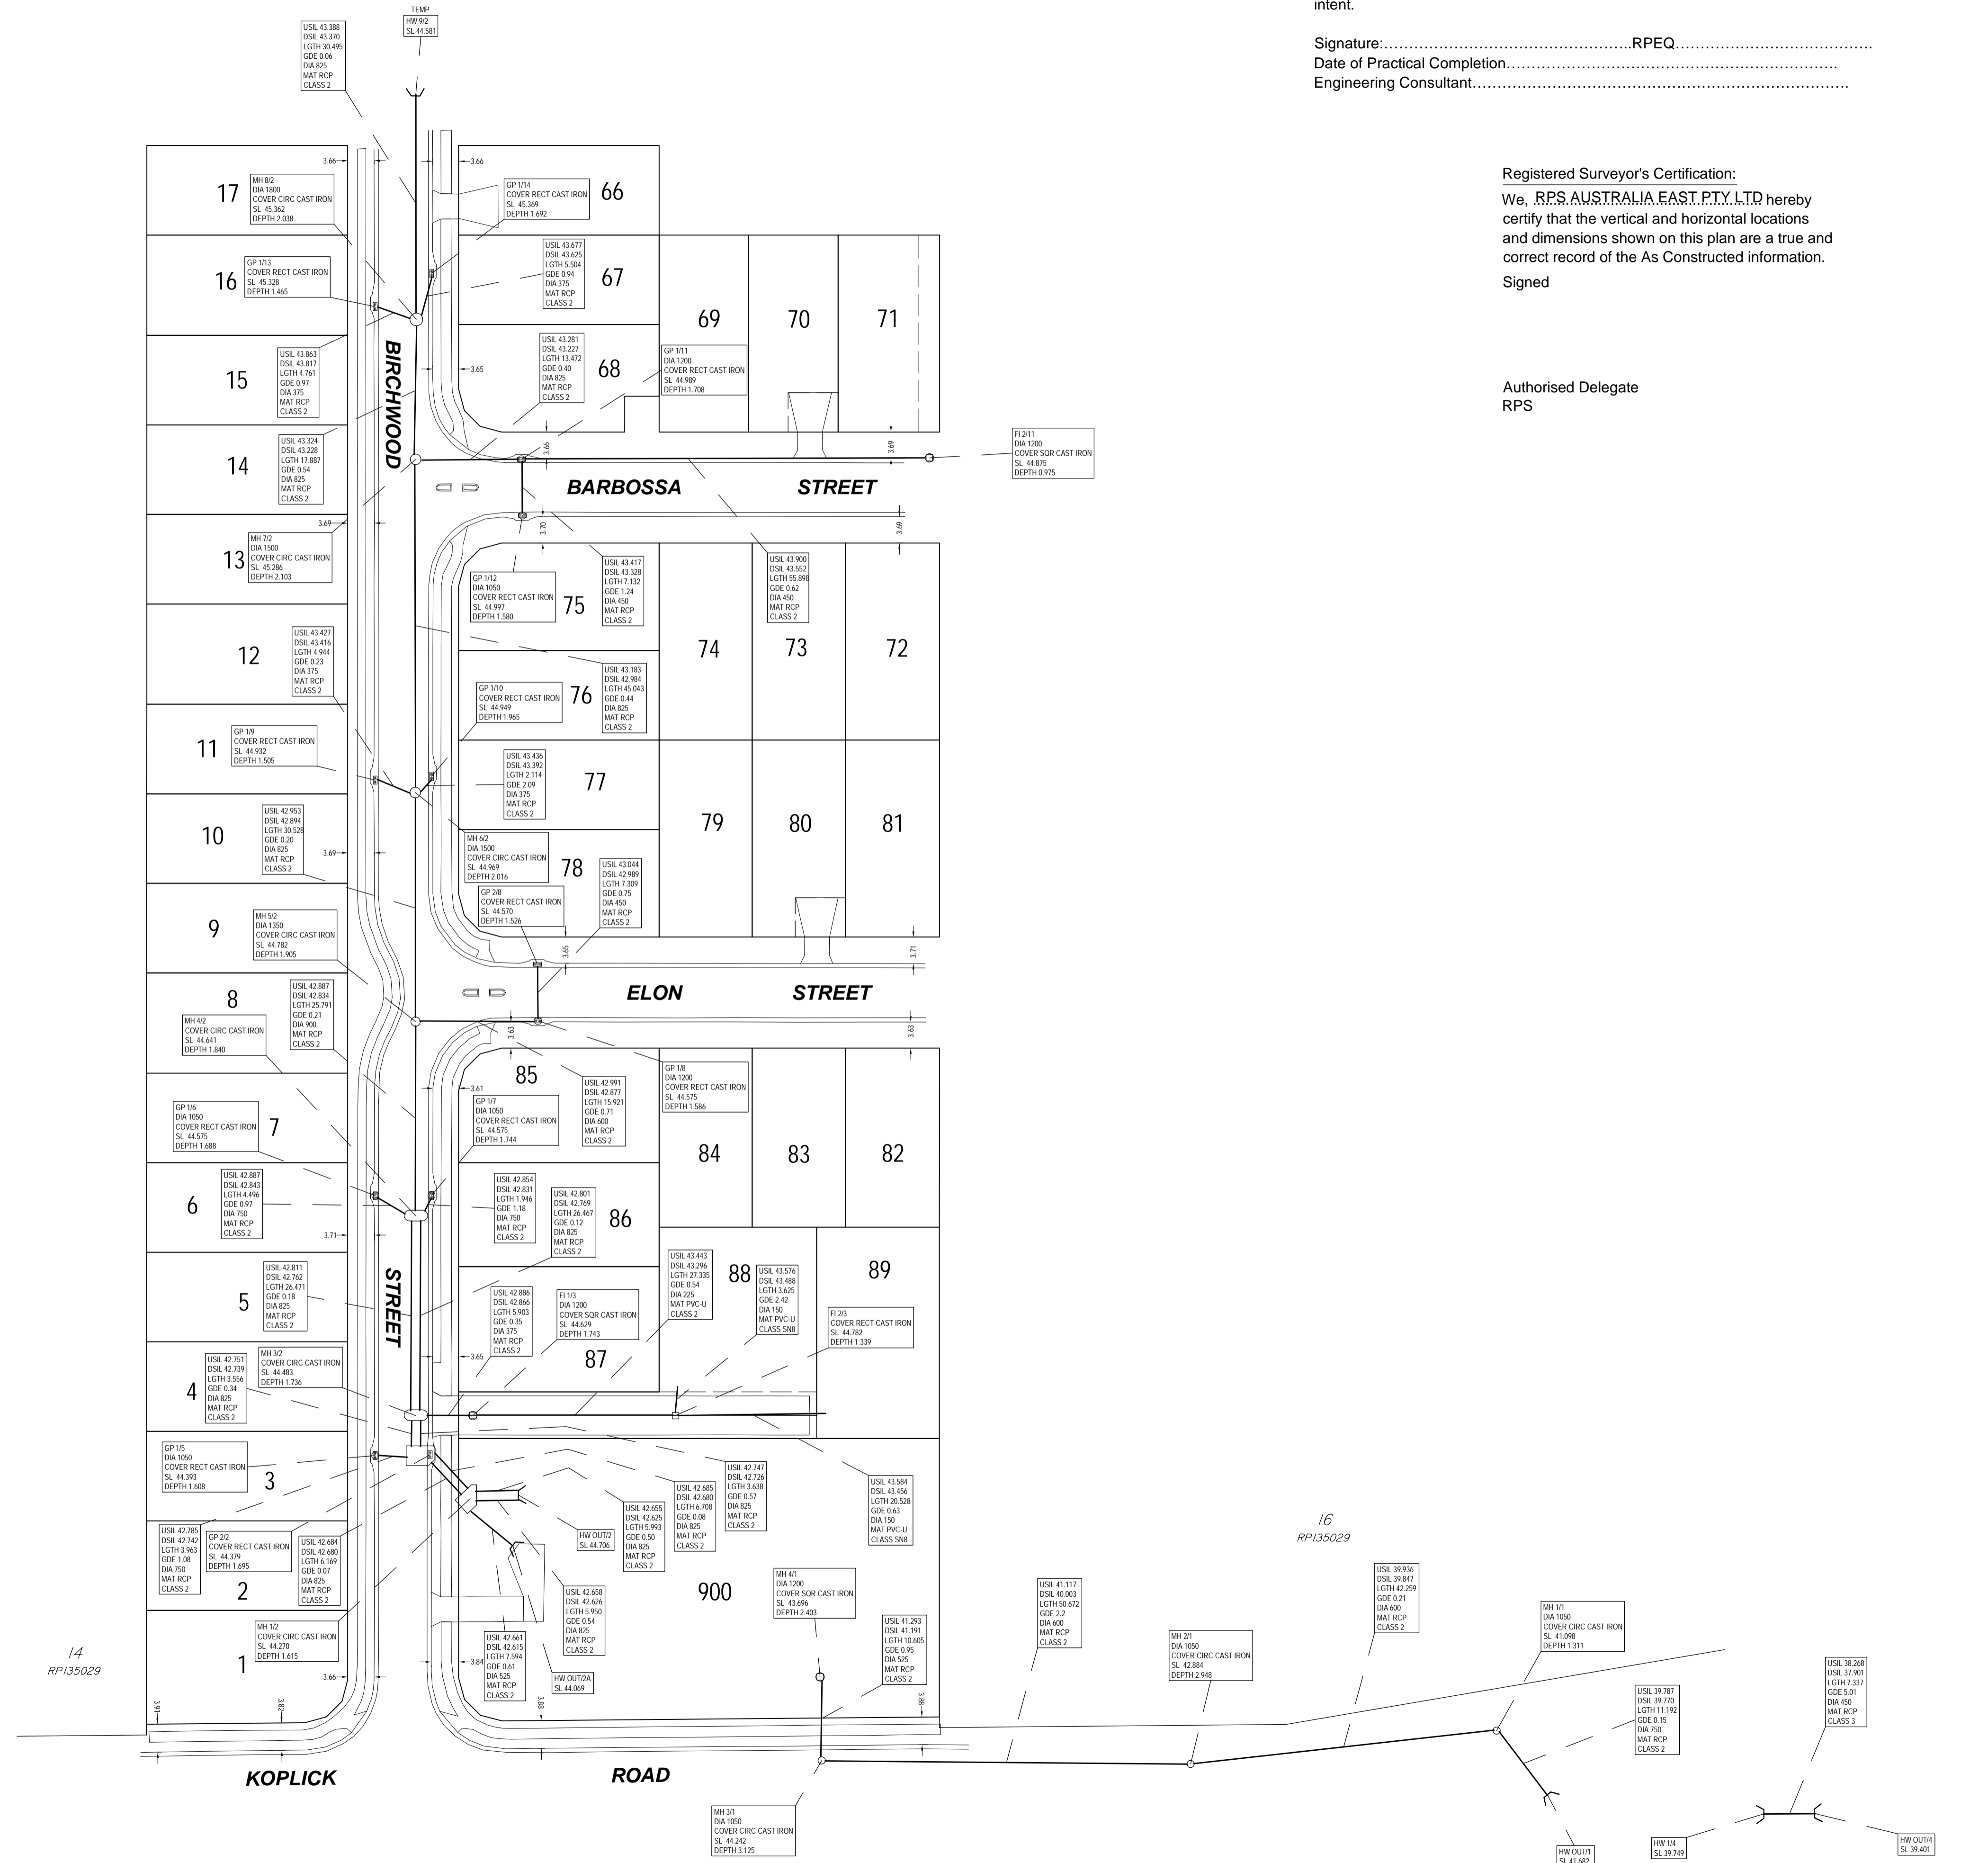

Scale 1:500@A1 - Lengths are in Metres.
 5 0 5 10 15 20 25 30 35 40 45 50 55 60 65 70