


WATER AS CONSTRUCTED

BIRCHWOOD
STAGE 1 & 2
PARK RIDGE

SHEET 1 of 2

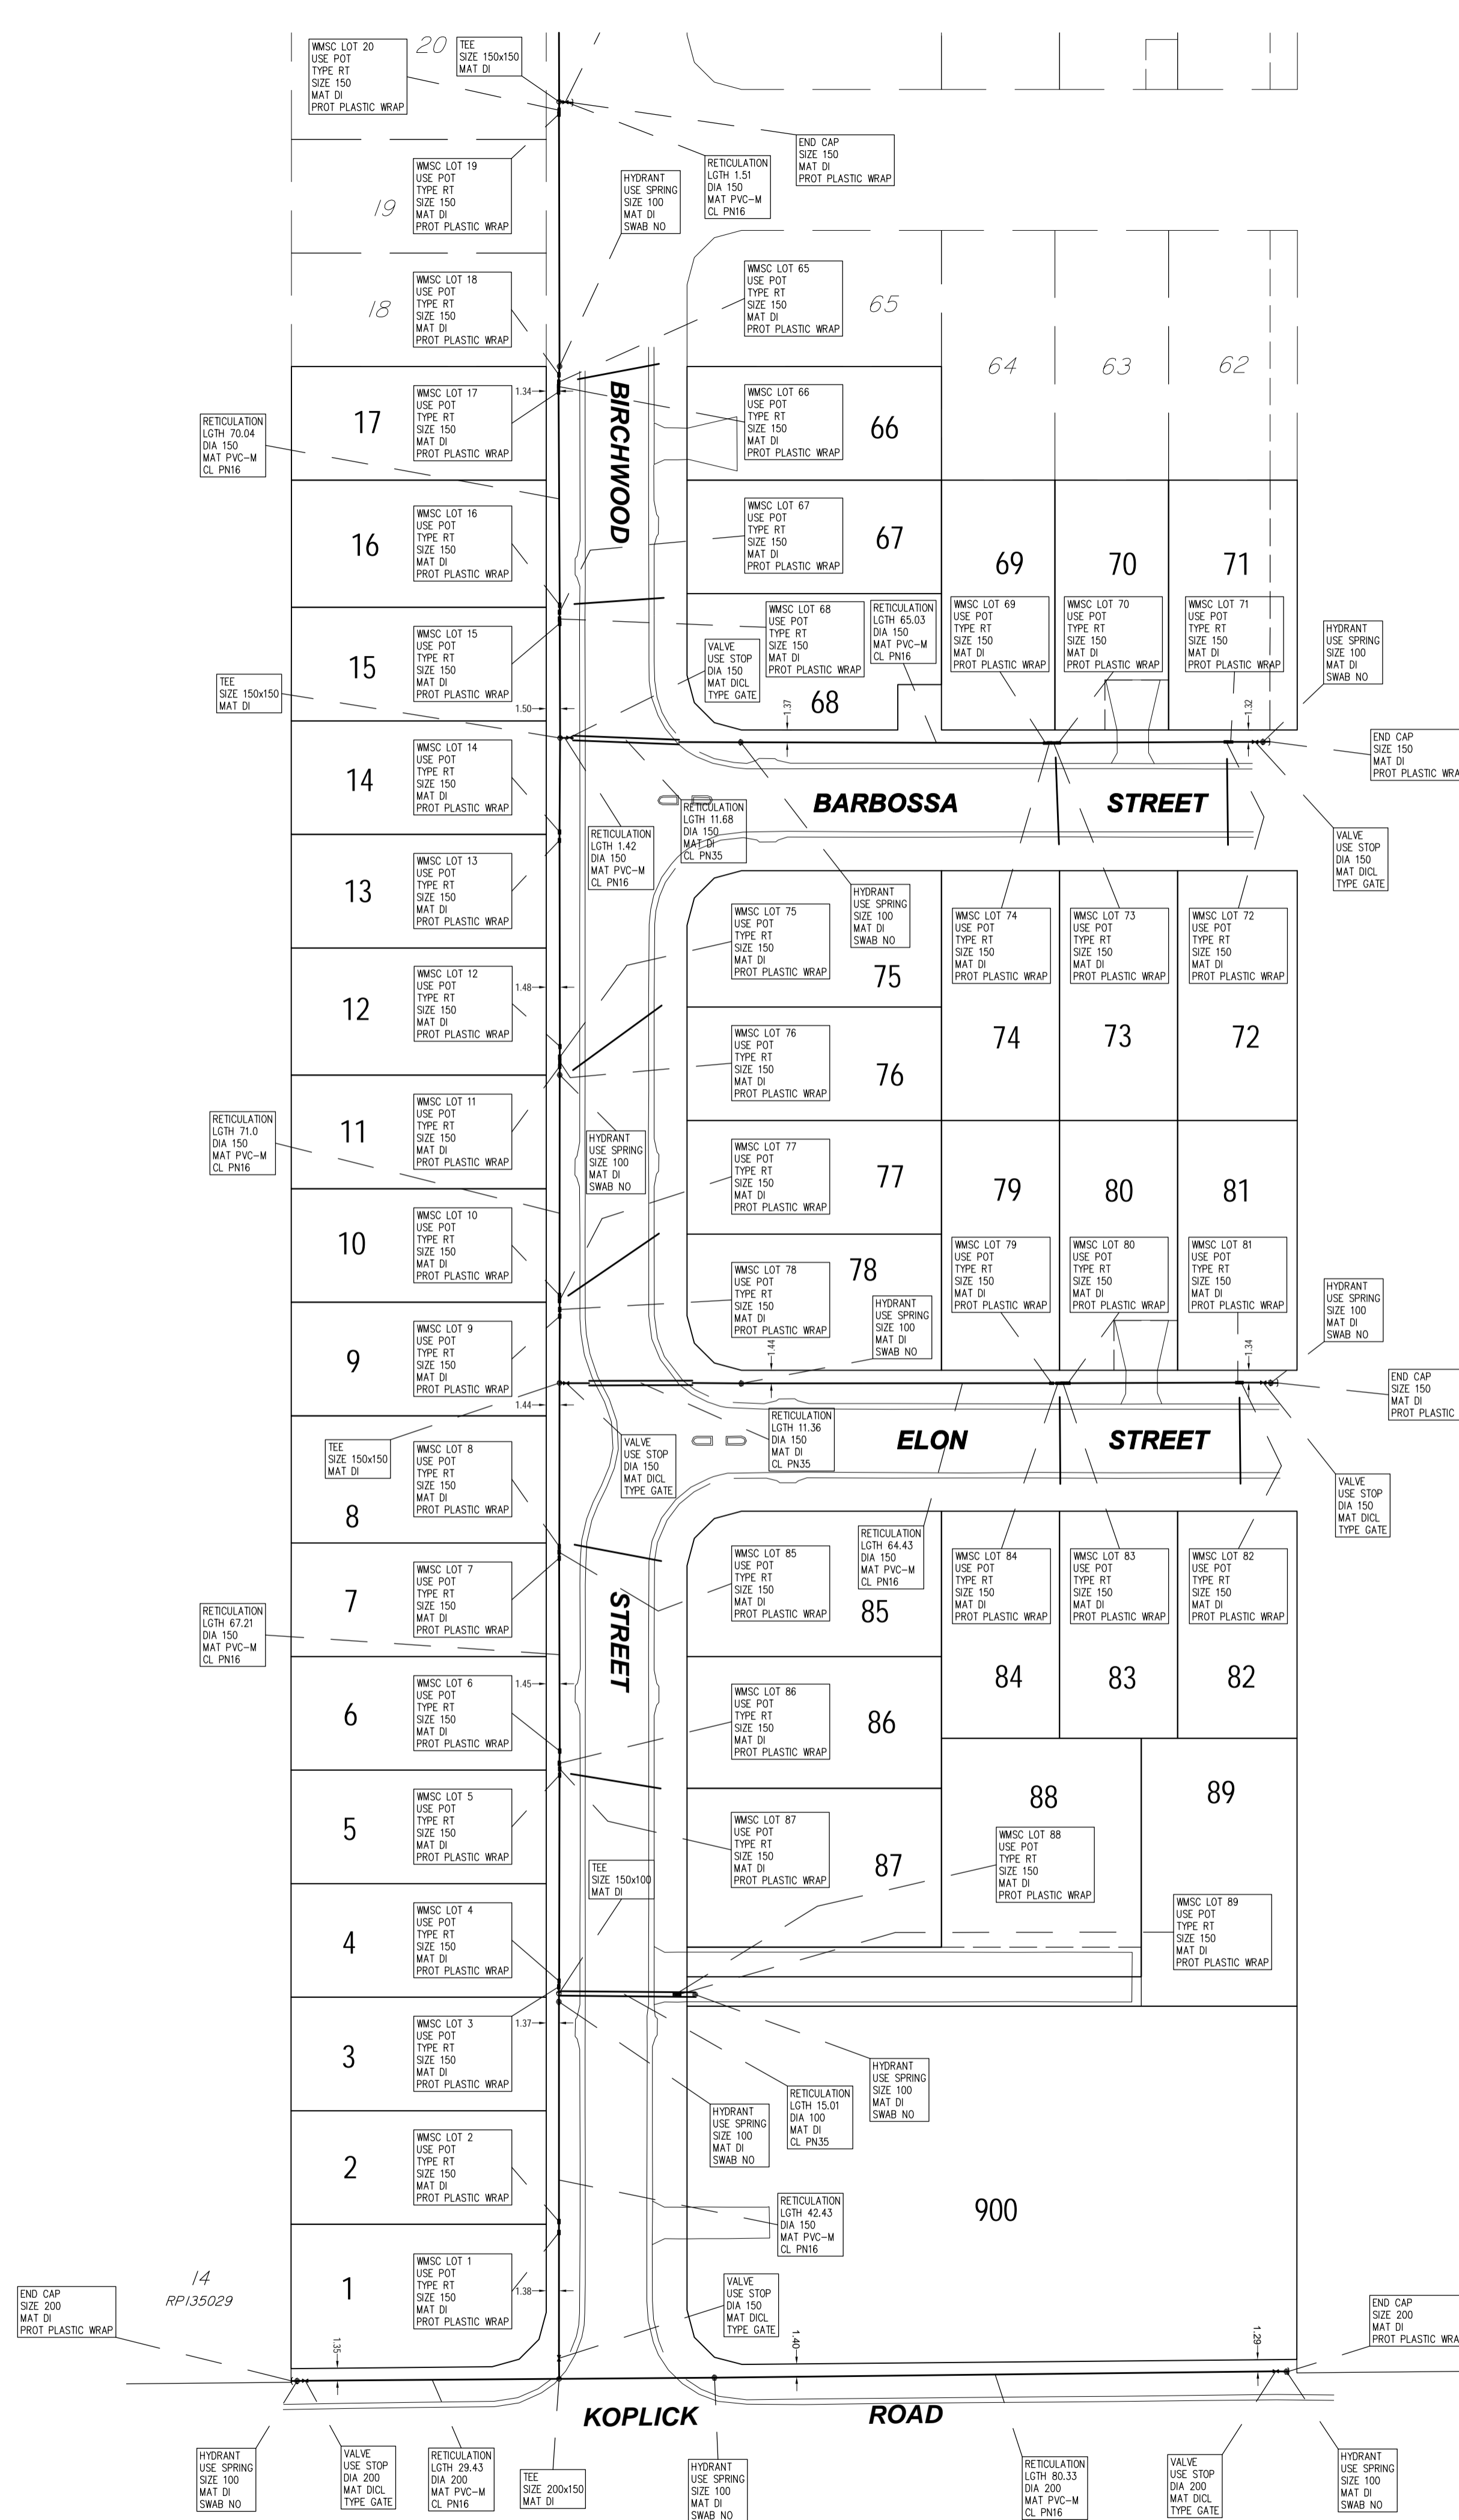


Consulting Engineer's Certification
 It is certified that works herein have been constructed to Local Government standards, relevant approved specifications and the operational works approval. The As-Constructed Drawings for these works constitutes a true and correct record of the works constructed and complies with the design intent.


Signature:RPEQ.....
 Date of Practical Completion.....
 Engineering Consultant.....

Registered Surveyor's Certification:
 We, RPS AUSTRALIA EAST PTY LTD hereby
 certify that the vertical and horizontal locations
 and dimensions shown on this plan are a true and
 correct record of the As Constructed information.
 Signed

Authorised Delegate
 RPS

16
 RP/135029

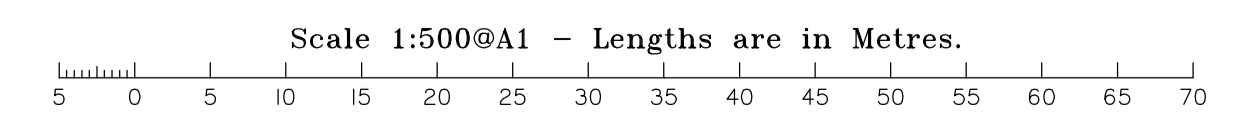

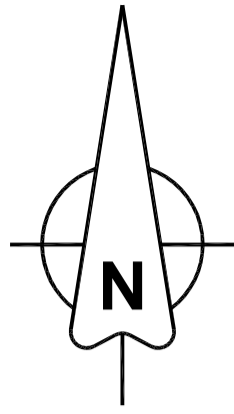

Denotes Logan Water live connection.

Consulting Engineer's Certification
 It is certified that works herein have been constructed to Local Government standards, relevant approved specifications and the operational works approval. The As-Constructed Drawings for these works constitutes a true and correct record of the works constructed and complies with the design intent.

Signature:.....RPEQ.....
 Date of Practical Completion.....
 Engineering Consultant.....

Registered Surveyor's Certification:
 We, RPS AUSTRALIA EAST PTY LTD hereby certify that the vertical and horizontal locations and dimensions shown on this plan are a true and correct record of the As Constructed information.
 Signed

Authorised Delegate
 RPS

**WATER
 AS CONSTRUCTED**

**BIRCHWOOD
 STAGE 1 & 2
 PARK RIDGE**

SHEET 2 of 2

